
MILL RIVER LEVEE REPAIR U.S. ARMY CORPS OF ENGINEERS WOONSOCKET FLOOD REDUCTION PROJECT WOONSOCKET, RI STATEMENT OF WORK JULY 2024


INFORMATIONAL PHOTOS AND PLANS



Informational Photo/Plan No. 1: Area of washout, Mill River left bank, looking downstream.

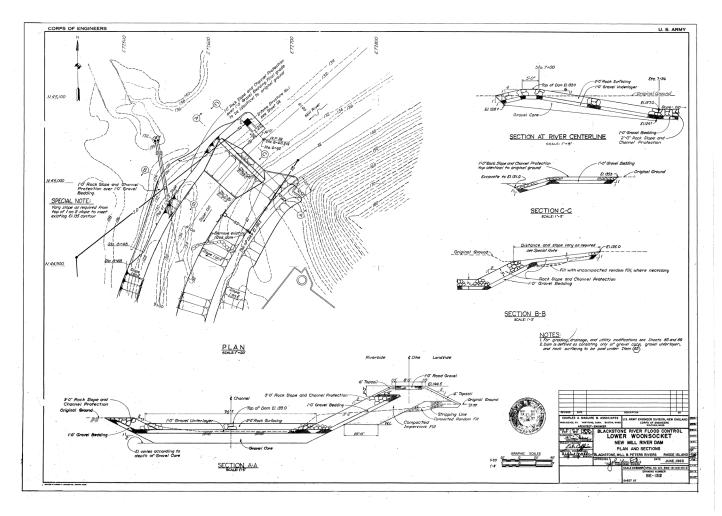

Informational Photo/Plan No. 2: Area of washout, Mill River left bank original as built plans.

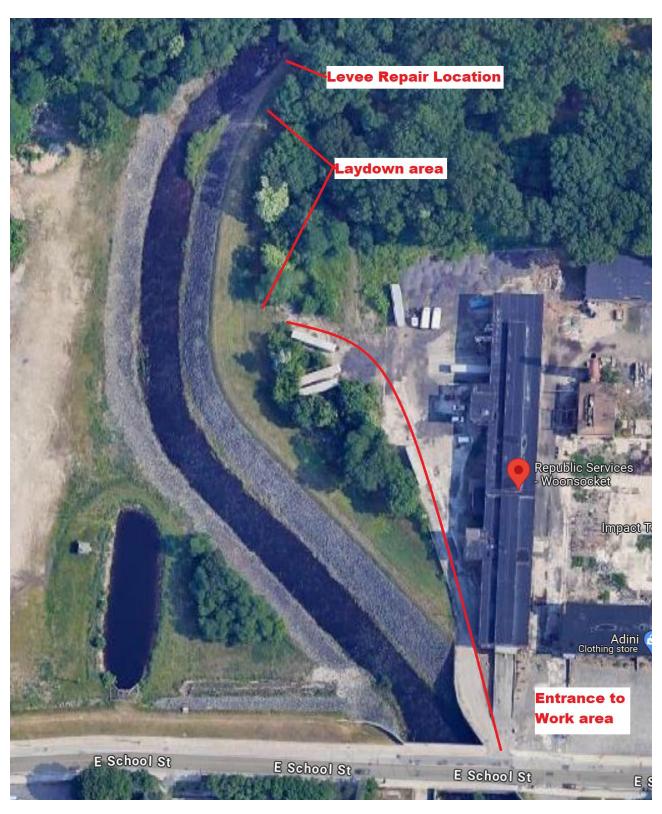

Informational Photo/Plan No. 3: Areal view of entrance, laydown and repair areas. Entrance address is 292 East School Street, Woonsocket, RI. 02895.

